


LEGEND

- (FH) FIRE HYDRANT/(DFH) DUCKFOOT
- (VS) STOP VALVE/(FP) FLUSHING POINT
- (VA) SCOUR ASSEMBLY
- (RT) READY TAP/(TB) TAPPING BAND
- (BV) BALL VALVE (SEQ 20Ø)
- END CAP
- TEE
- (RE) REDUCER
- BEND
- DICL WATER MAIN CROSSING
- CONDUIT/CROSSING
- EXISTING WATER

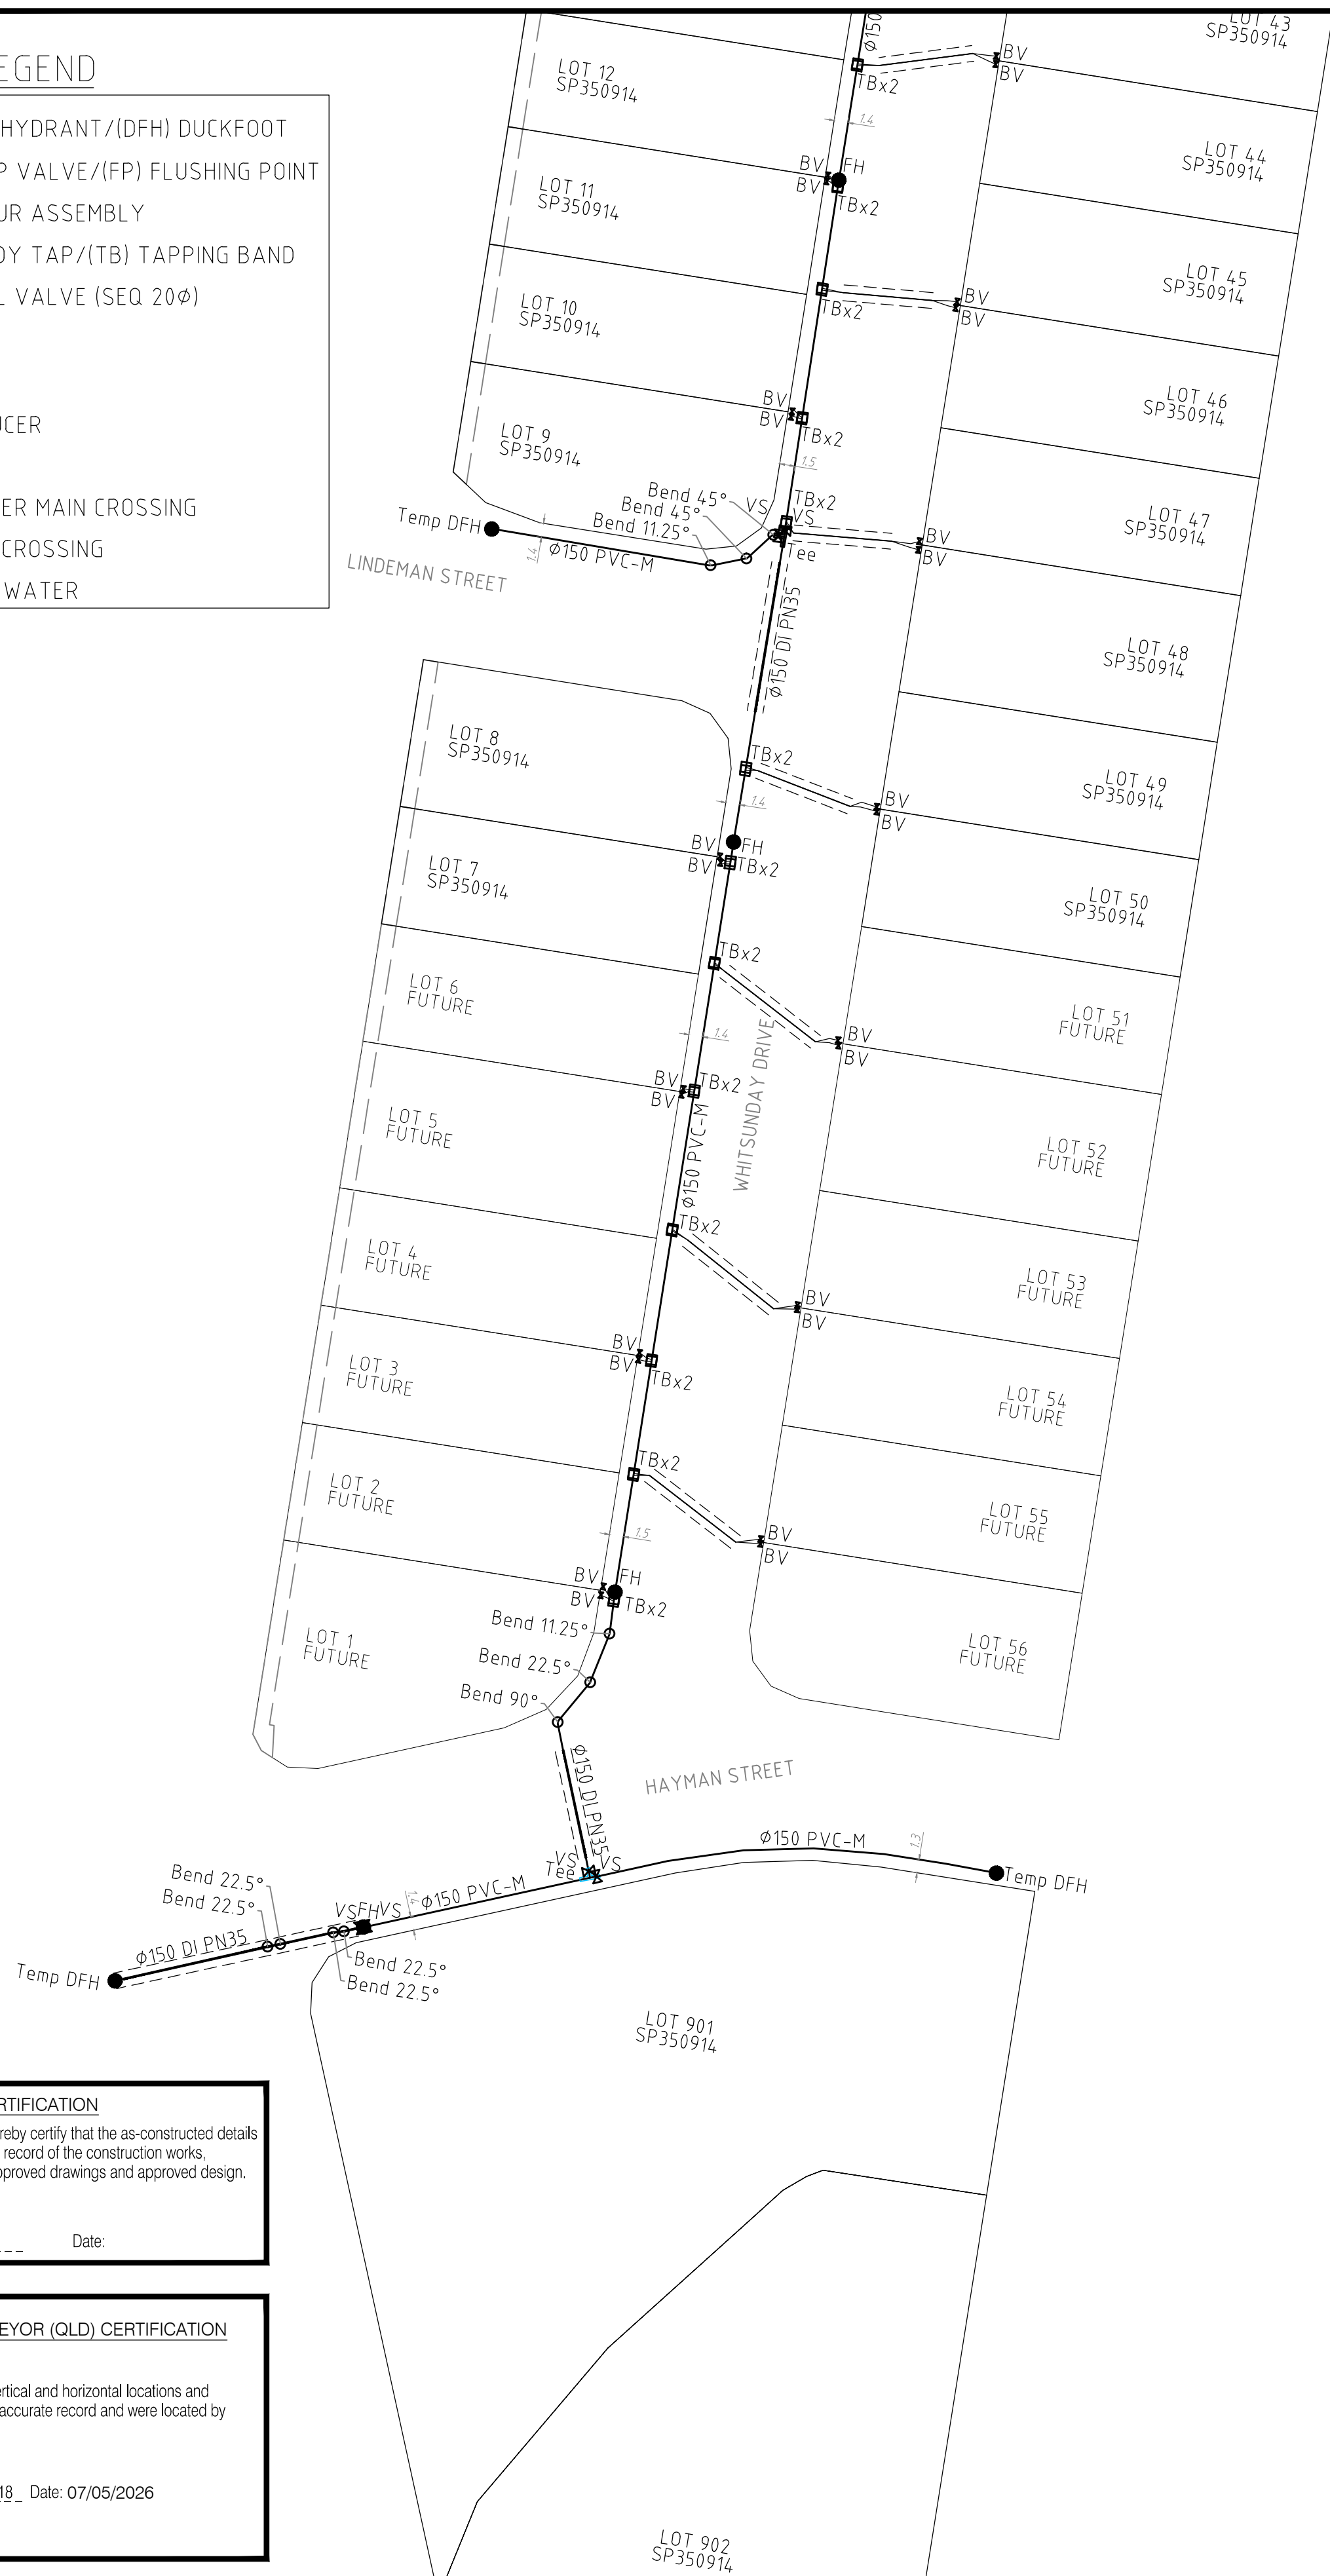


ENGINEER'S CERTIFICATION
I, **Brian Lees**, hereby certify that the as-constructed details shown on this drawing are a true and accurate record of the construction works, in compliance with the contract documents, approved drawings and approved design.


RPEQ (signature) RPEQ No. Date:

REGISTERED CADASTRAL SURVEYOR (QLD) CERTIFICATION
LandPartners Pty Ltd, hereby certify that the vertical and horizontal locations and dimensions shown on this plan are a true and accurate record and were located by survey.

R. G. Anderson
Authorised Delegate Reg. Surveyor No. 4118 Date: 07/05/2026
LandPartners Pty Ltd
Registered QLD Surveyor Corporation

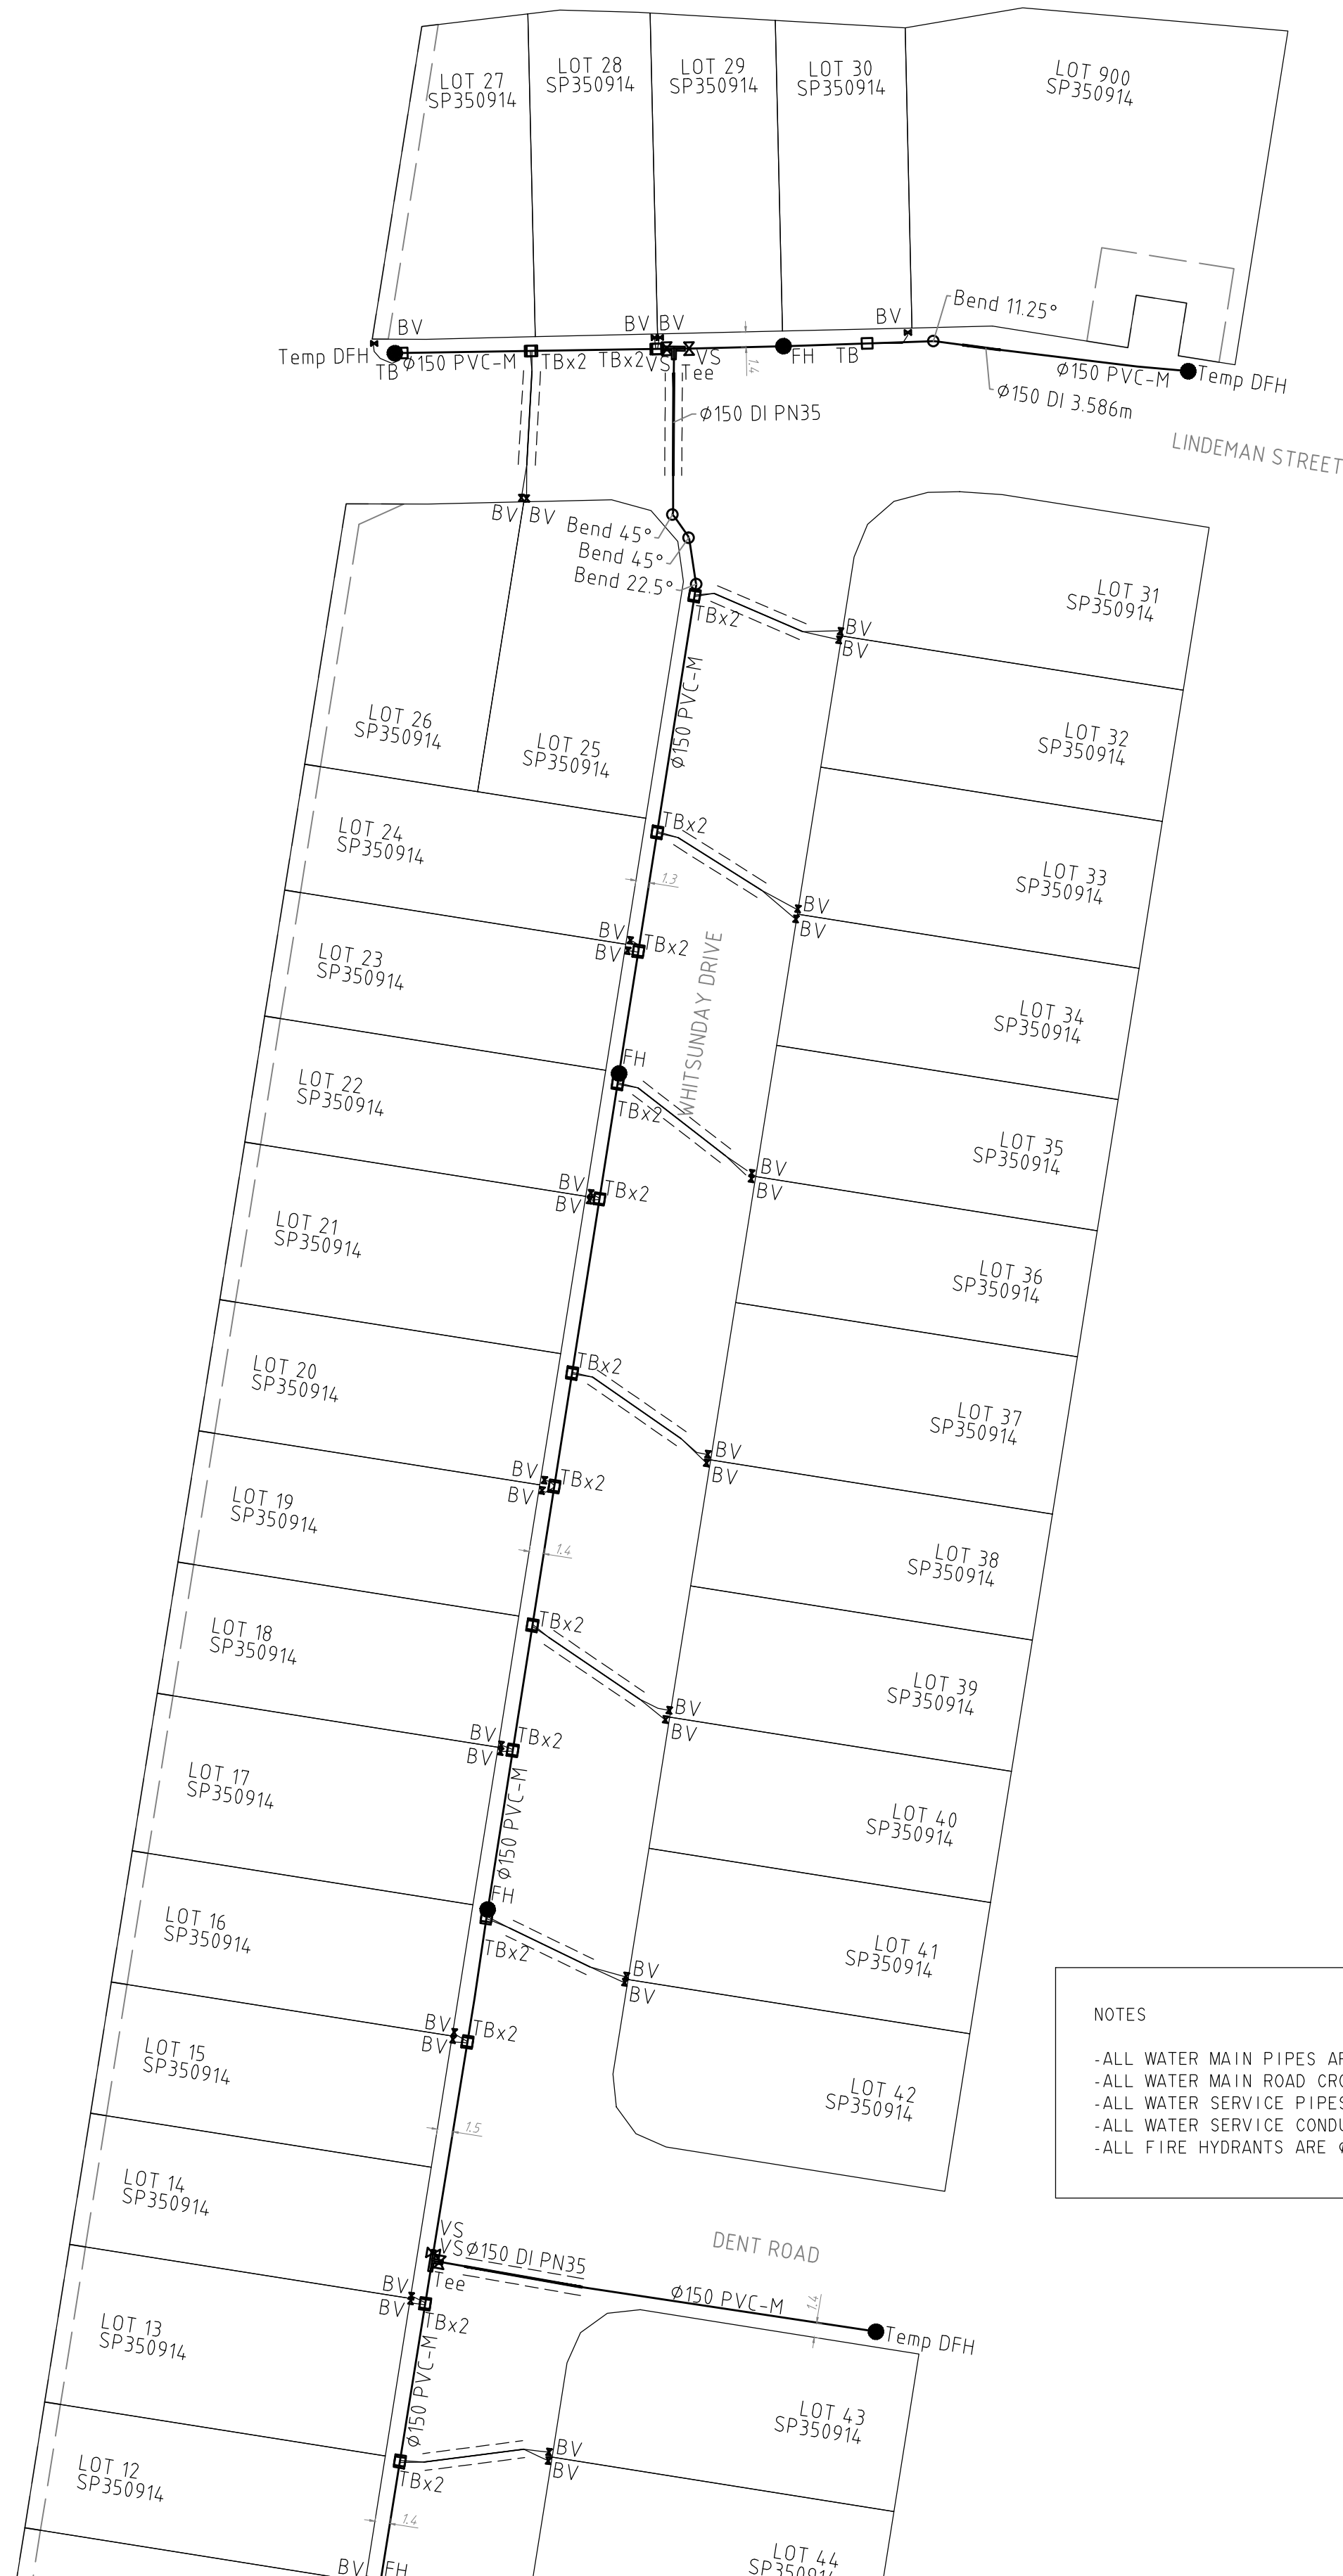

- NOTES
- ALL WATER MAIN PIPES ARE Ø150 PVC-M CLASS 'PN16' U.N.O.
 - ALL WATER MAIN ROAD CROSSINGS ARE Ø150 DICL CLASS 'PN35'
 - ALL WATER SERVICE PIPES ARE Ø25 PE-100 CLASS 'PN16'
 - ALL WATER SERVICE CONDUIT CROSSINGS ARE Ø100 PVC-M CLASS 'PN9'
 - ALL FIRE HYDRANTS ARE Ø100 SPRING

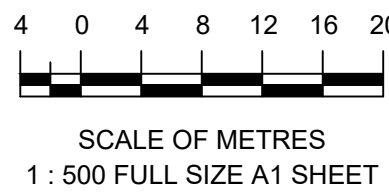

A1

REV NO	DATE	REVISION PURPOSE / DESCRIPTION	DRAWN	RPEQ	RPEQ No	INITIALS	DATE
3	07/05/2026	UPDATE OF PIPE DETAILS	VO				07/05/2026
2	29/04/2026	PIPE MATERIAL CHANGE	MJK				07/05/2026
1	22/04/2026	INITIAL ISSUE	MJK				07/05/2026

MNG
LANDPARTNERS

Brisbane Office
Level 1
18 Little Cribb Street
Milton QLD 4064

p: (07) 3842 1000
e: brisbane@mnglandpartners.com.au
w: www.landpartners.com.au

Perth | Brisbane | Melbourne | Sydney | Broome | South West WA

ORCHARD PROPERTY GROUP

ALTO - STAGE 1
52 LINDENTHAL ROAD, PARK RIDGE
AS-CONSTRUCTED
WATER

DRAWING STATUS	
AS CONSTRUCTED	
SHEET 1 OF 1 SHEETS	
DRAWING NO.	REV.
BRSS8087-001-9-3	3