
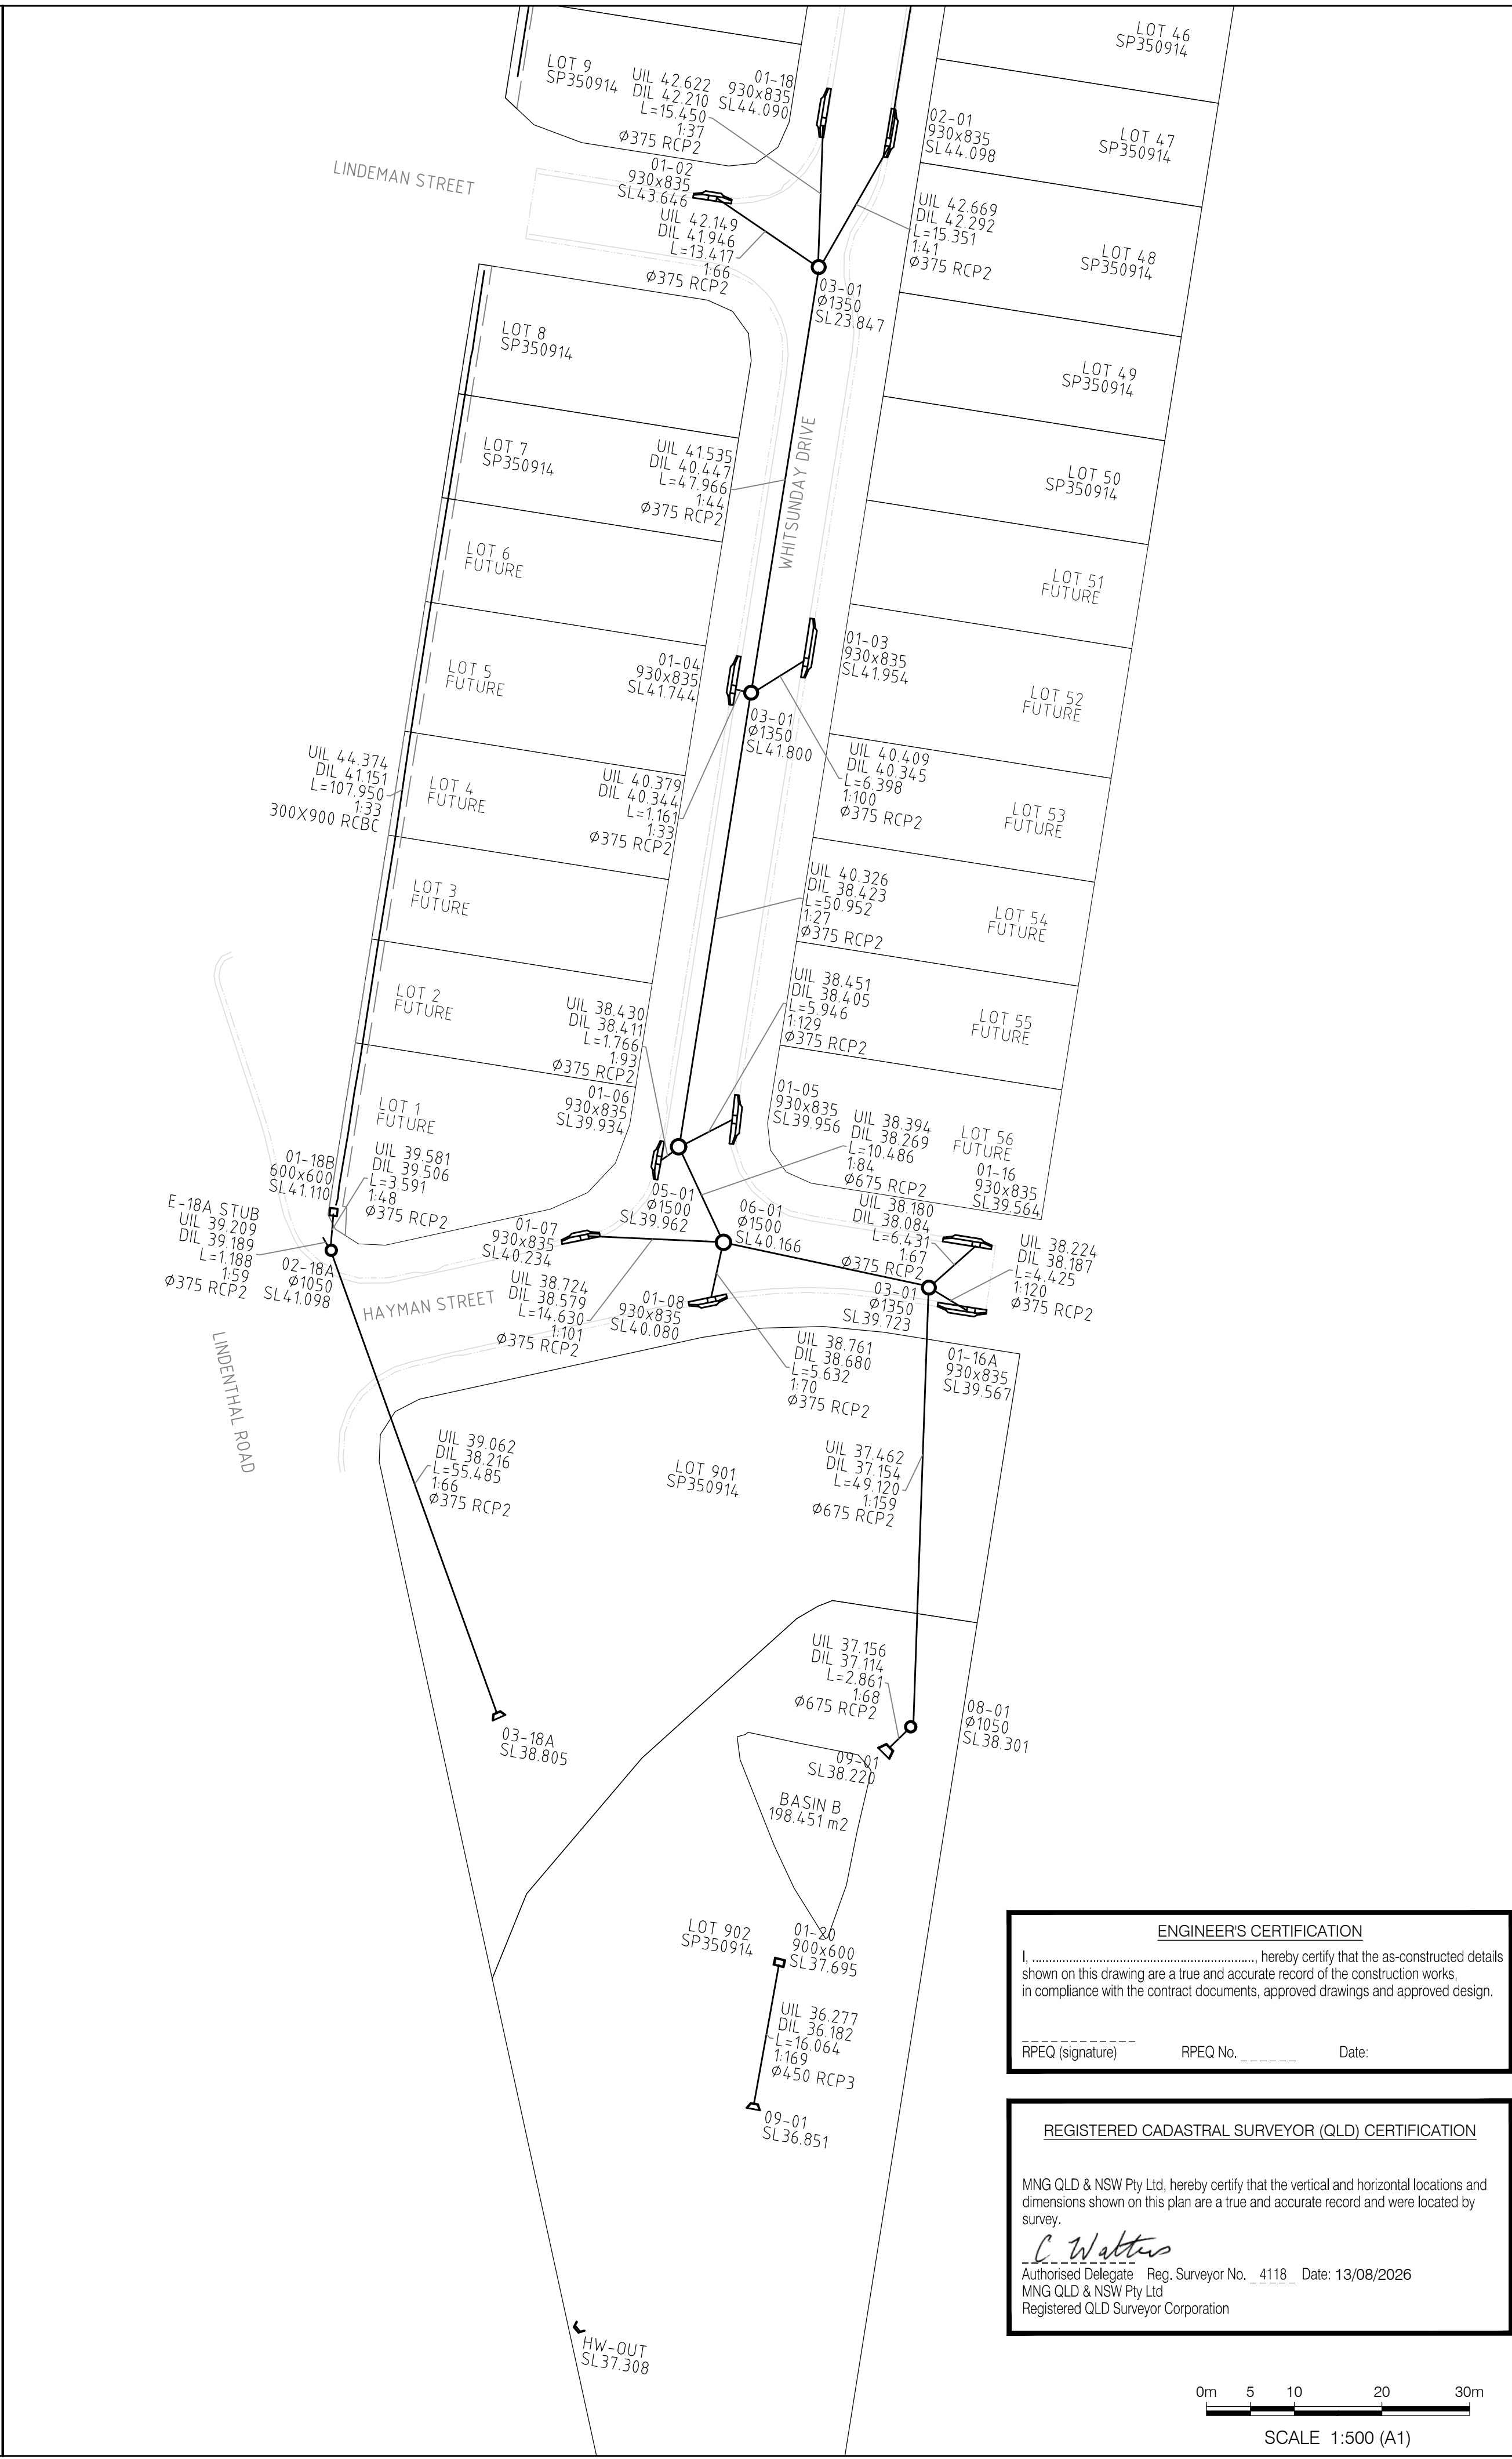


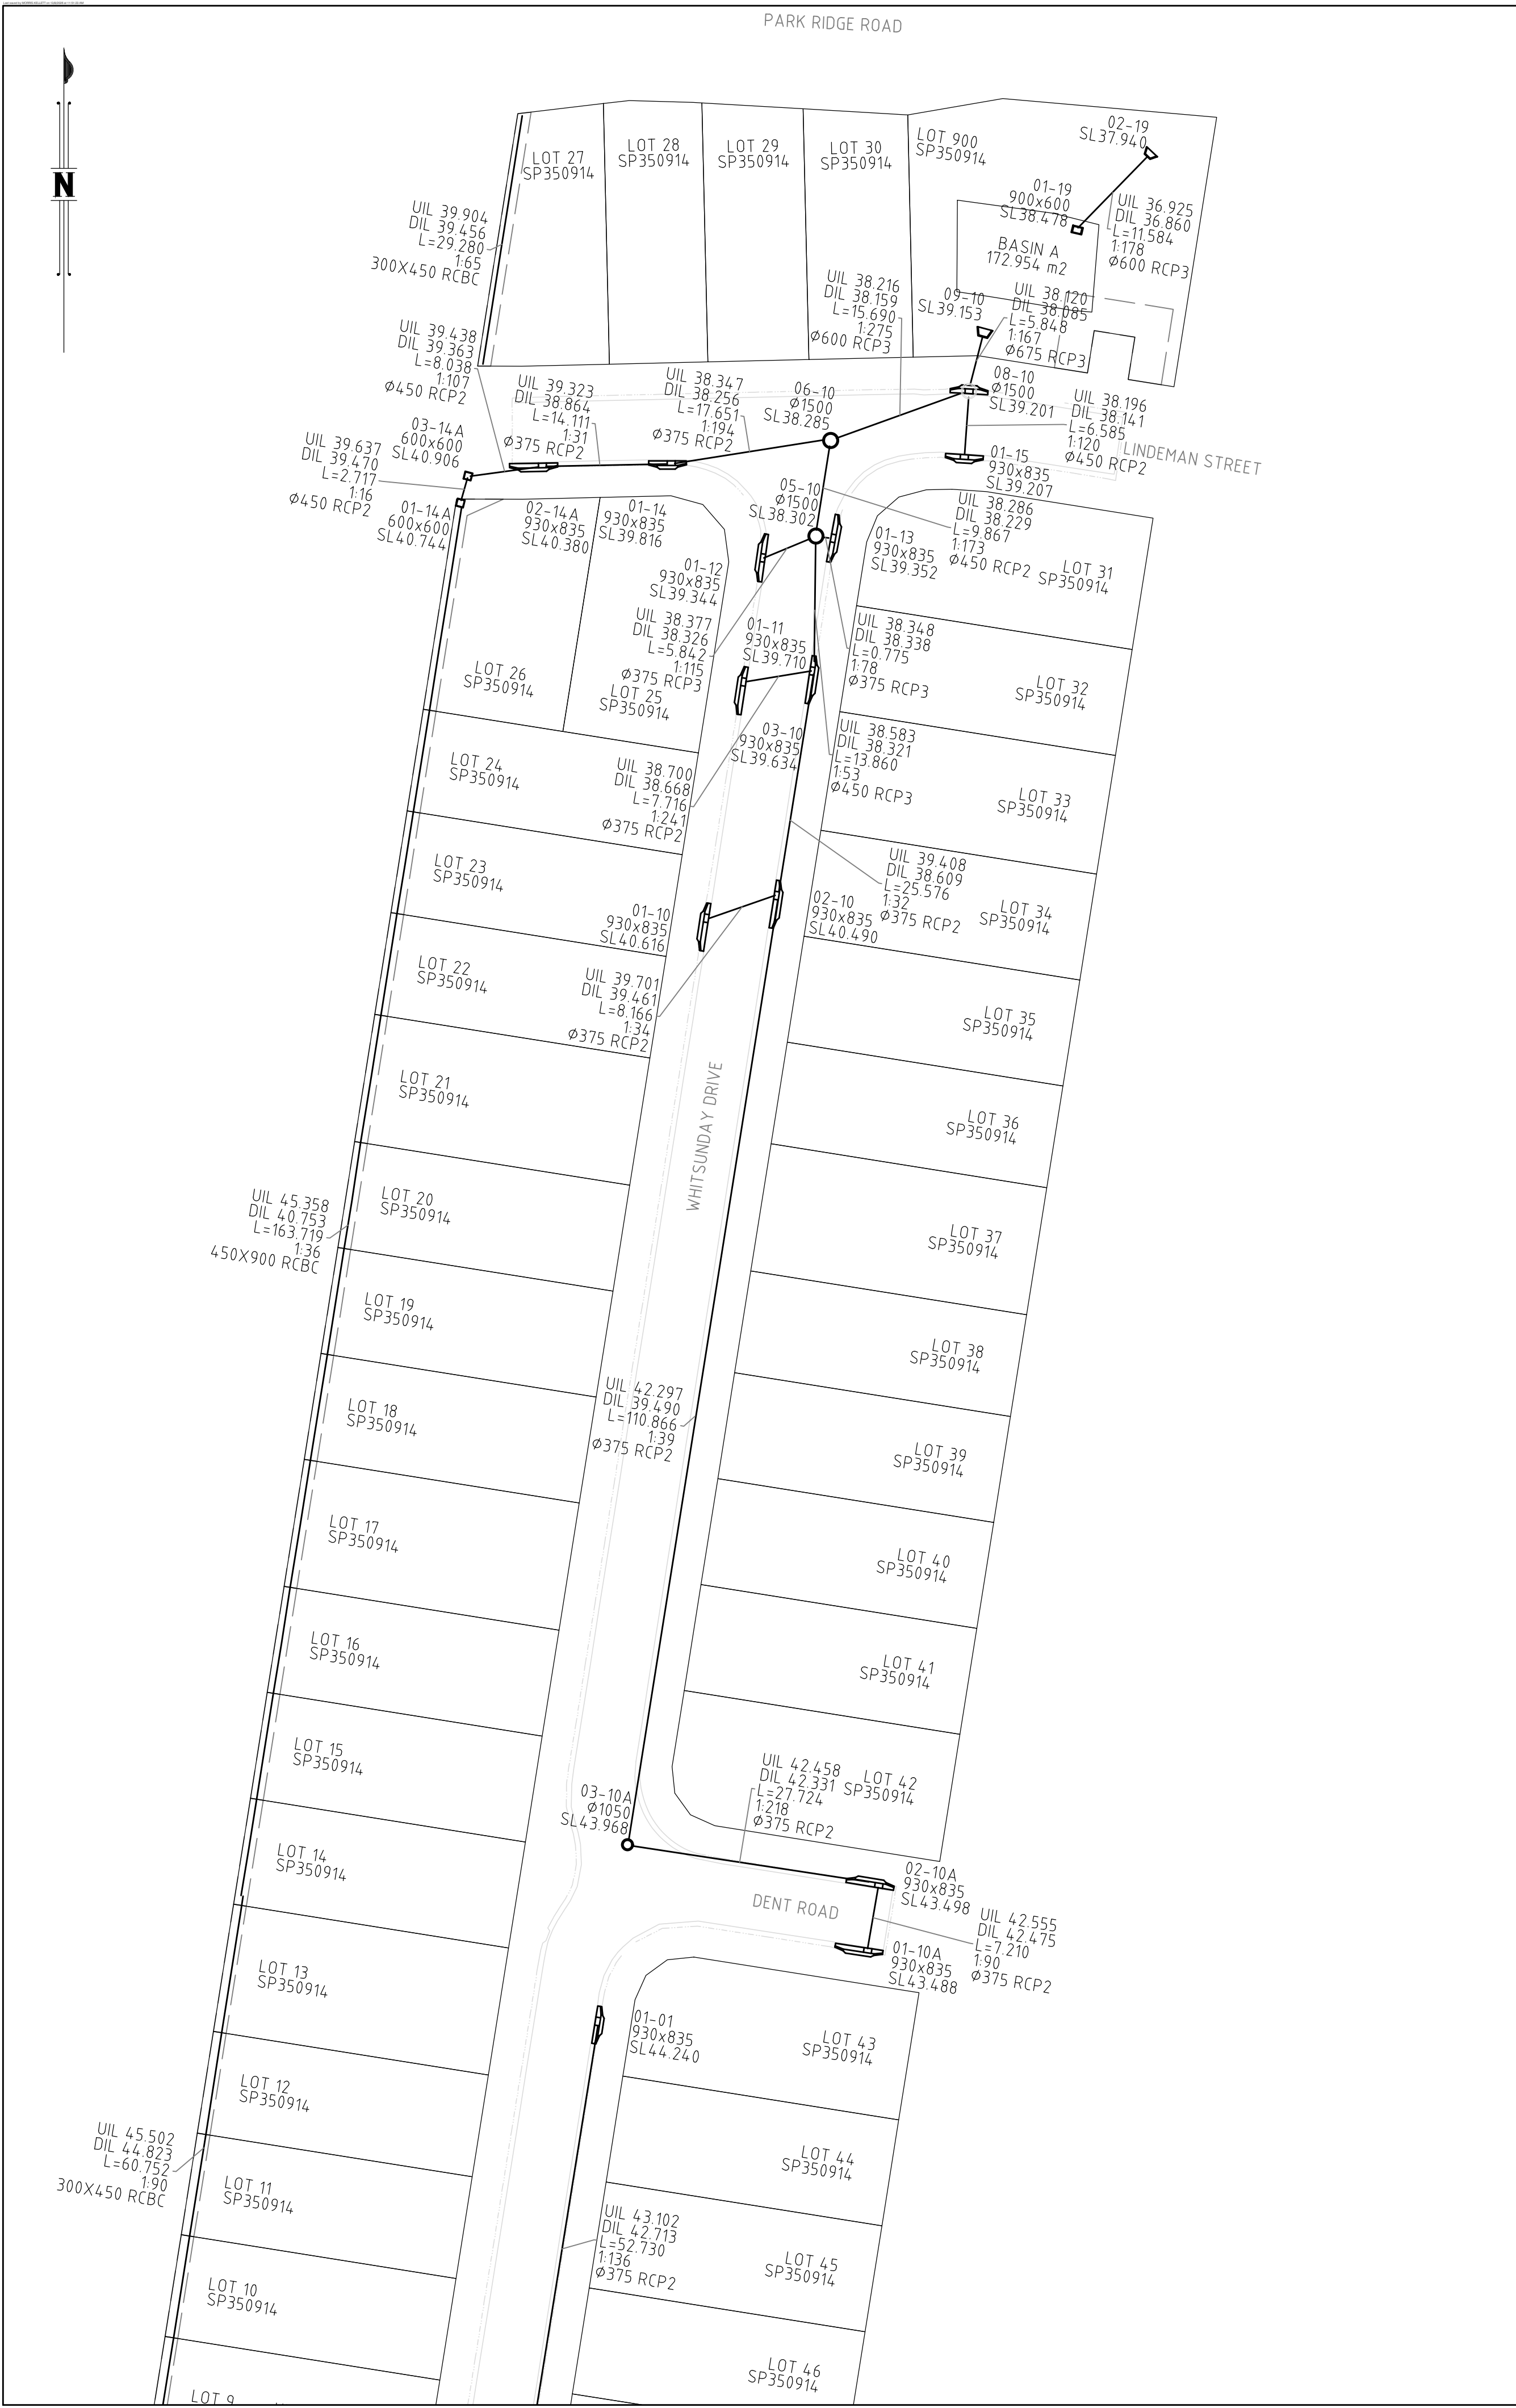

CLIENT

ORCHARD PROPERTY GROUP PTY LTD

PROJECT

AS CONSTRUCTED STORMWATER OF ALTO STAGE 1 52 LINDENTHAL RD, PARK RIDGE

NOTES

-ALL STORMWATER DRAINAGE PIPES ARE RCP U.N.O.

ENGINEERING FIRM:

BURCHILLS ENGINEERING SOLUTIONS

1	13/08/2026	MJK	CGW	CGW	INITIAL ISSUE
REV	DATE	DRAWN	CHECKED	APPROVED	NOTE

MNG

Brisbane Office
Level 3
108 Wickham Street
Fortitude Valley QLD 4006

p: (07) 3842 1000
e: brisbane@mngsurvey.com.au
w: mngsurvey.com.au

Perth | Brisbane | Melbourne | Sydney | Broome | South West WA

LEVEL DATUM
AHD

LOCAL AUTHORITY
LOGAN C.C.

LEVEL ORIGIN
-

CONTOUR INTERVAL
-

MERIDIAN
MGA2020

CO-ORD SYSTEM
MGA ZONE 56

UDN

BRSS8087-001-13-1

ENGINEER'S CERTIFICATION

I, _____, hereby certify that the as-constructed details shown on this drawing are a true and accurate record of the construction works, in compliance with the contract documents, approved drawings and approved design.

RPEQ (signature) RPEQ No. _____ Date: _____

REGISTERED CADASTRAL SURVEYOR (QLD) CERTIFICATION

MNG QLD & NSW Pty Ltd, hereby certify that the vertical and horizontal locations and dimensions shown on this plan are a true and accurate record and were located by survey.

C. Walters

Authorised Delegate Reg. Surveyor No. 4118 Date: 13/08/2026

MNG QLD & NSW Pty Ltd

Registered QLD Surveyor Corporation

0m 5 10 20 30m

SCALE 1:500 (A1)

© MNG Survey 2026