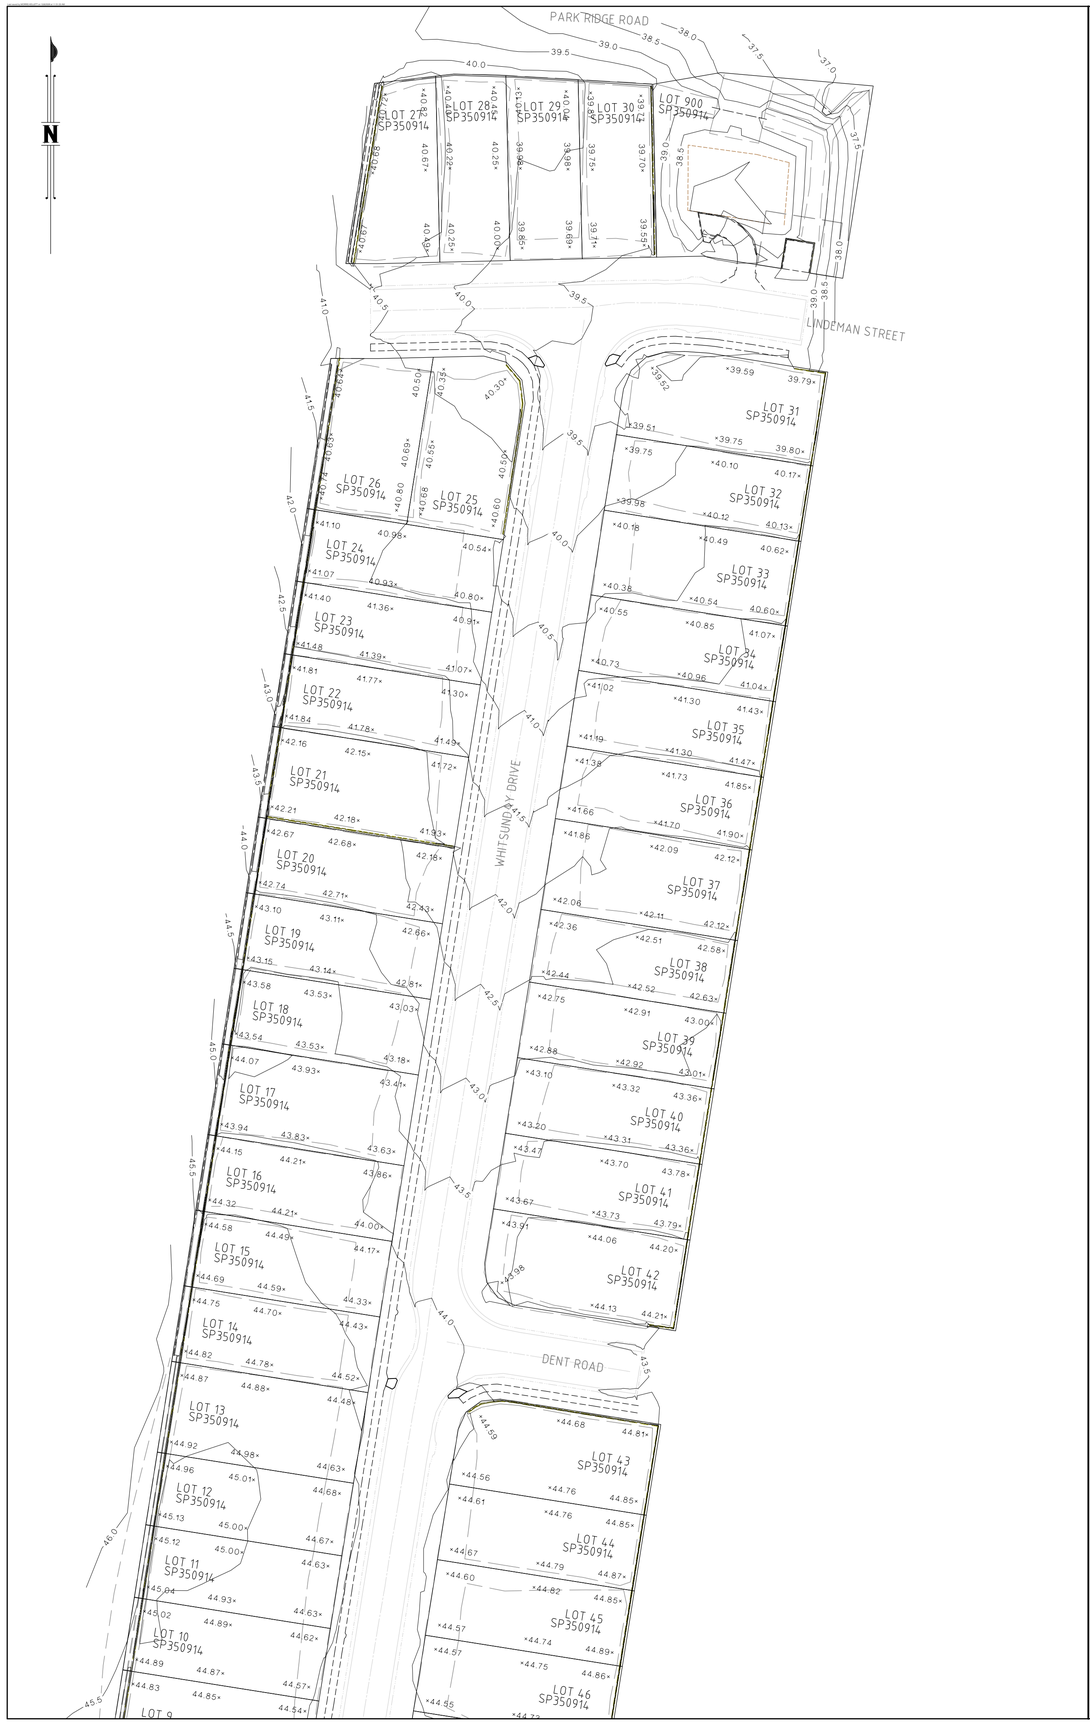

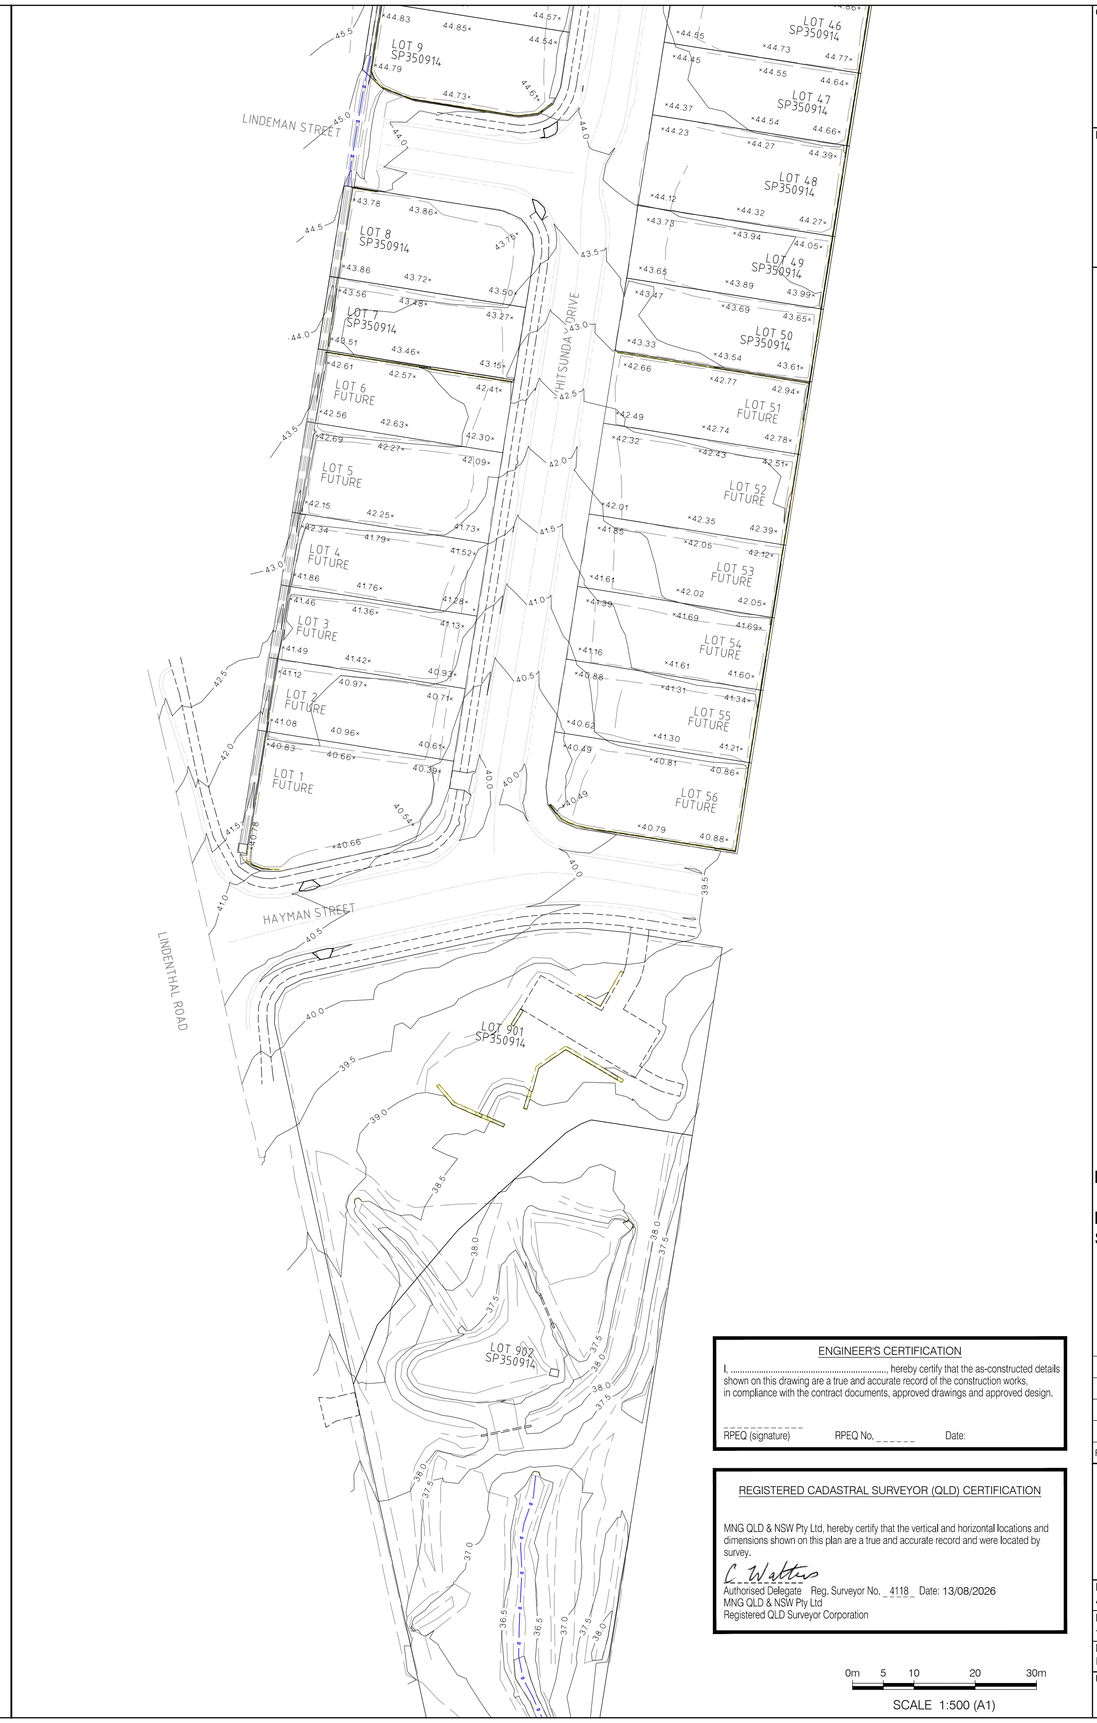

ENGINEER'S CERTIFICATION

I, ..., hereby certify that the as-constructed details shown on this drawing are a true and accurate record of the construction works, in compliance with the contract documents, approved drawings and approved design.

_ _ _ _ _ _ _ _ _ _ _ _
RPEQ (signature) RPEQ No. _ _ _ _ _ _ Date:

REGISTERED CADASTRAL SURVEYOR (QLD) CERTIFICATION

MNG QLD & NSW Pty Ltd, hereby certify that the vertical and horizontal locations and dimensions shown on this plan are a true and accurate record and were located by survey.

C. Walters
Authorised Delegate Reg. Surveyor No. _4118_ Date: 13/08/2026
MNG QLD & NSW Pty Ltd
Registered QLD Surveyor Corporation

0m 5 10 20 30m
SCALE 1:500 (A1)

CLIENT

ORCHARD PROPERTY GROUP PTY LTD

PROJECT

AS CONSTRUCTED TOPOGRAPHY
OF
ALTO STAGE 1
52 LINDENTHAL RD, PARK RIDGE

LEGEND

- BOTTOM OF WALL
- TOP OF WALL
- LIP OF KERB
- BACK OF KERB
- EDGE OF CONCRETE
- EDGE OF ROCK
- CONTOURS
- CHANGE OF GRADE
- BOTTOM OF BANK
- TOP OF BANK
- CROWN OF ROAD
- DRAIN CENTRELINE

ENGINEERING FIRM:

BURCHILLS ENGINEERING SOLUTIONS

REV	DATE	DRAWN	CHECKED	APPROVED	NOTE
1	13/08/2026	MJK	CGW	CGW	INITIAL ISSUE

MNG
Brisbane Office
Level 3
108 Wickham Street
Fortitude Valley QLD 4006
p: (07) 3842 1000
e: brisbane@mngsurvey.com.au
w: mngsurvey.com.au
Perth | Brisbane | Melbourne | Sydney | Broome | South West WA

LEVEL DATUM AHD	LOCAL AUTHORITY LOGAN C.C.
LEVEL ORIGIN -	CONTOUR INTERVAL 0.5 Metre
MERIDIAN MGA2020	CO-ORD SYSTEM MGA ZONE 56

UDN SHEET 1 OF 1

BRSS8087-001-14-1

© MNG Survey 2026